

Work Order ID 106848

September-11-13 11:47:08 AM

106848

Page 1

Item ID: 646.3715

Revision ID:

Item Name: Strut Doubler

Start Date: 9/23/13

Start Qty: 16.00

16

Required Date: 9/23/13

Req'd Qty: 16.00

16

Reference:

Accept

N900040100

Setup Start

NS1

Stop

NS2

Cust Item ID:

Customer:

Approvals:

Process Plan: MLJ

Date: 13-09-12

Tooling:

Date:

QC:

Date:

SPC (Y/N):

Date:

Run Start

NR1

Stop

NR2

Sequence ID/
Work Center ID

Operation
Description

Set Up/
Run Hours

Tool ID

Tool #

Plan
Code

Accept
Qty

Reject
Qty

Reject
Number

Insp.
Stamp

Draw Nbr

Revision Nbr

646.3700

A

110

0.00

110

Waterjet

FLOW CNC Waterjet

Memo

1-Cut as per Dwg

Dwg Rev: A

Prog Rev: A

2-Deburr if necessary

0.00

16

0

Ac

13.11.02

120

QC2- Inspect parts off machine FAI/FAIB

0.00

120

QC

Quality Control

Memo

0.00

16

0

Ac

13.11.02

NCR: Yes / No

WORK ORDER NON-CONFORMANCE / UPDATE

DQA: _____ Date: _____

QA Closed: _____ Date: _____

Work Order: _____ Part No. _____ NCR No. _____	DISPOSITION Rework <input type="checkbox"/> Scrap <input type="checkbox"/> Use-as-is <input type="checkbox"/> Work Order Update <input type="checkbox"/>	AGAINST DEPARTMENT/PROCESS <table style="width:100%; border: none;"> <tr> <td style="width:25%;">Skid-tube <input type="checkbox"/></td> <td style="width:25%;">Crosstube <input type="checkbox"/></td> <td style="width:25%;">Water Jet <input type="checkbox"/></td> <td style="width:25%;">Engineering <input type="checkbox"/></td> </tr> <tr> <td>Machining <input type="checkbox"/></td> <td>Small Fab <input type="checkbox"/></td> <td>Prod. Eng. Coord. <input type="checkbox"/></td> <td>Quality <input type="checkbox"/></td> </tr> <tr> <td>Thermoforming <input type="checkbox"/></td> <td>Finishing <input type="checkbox"/></td> <td>Rec/Store/Packaging <input type="checkbox"/></td> <td>Other <input type="checkbox"/></td> </tr> <tr> <td>Large Fab <input type="checkbox"/></td> <td>Composite <input type="checkbox"/></td> <td>Supplier <input type="checkbox"/></td> <td></td> </tr> </table>	Skid-tube <input type="checkbox"/>	Crosstube <input type="checkbox"/>	Water Jet <input type="checkbox"/>	Engineering <input type="checkbox"/>	Machining <input type="checkbox"/>	Small Fab <input type="checkbox"/>	Prod. Eng. Coord. <input type="checkbox"/>	Quality <input type="checkbox"/>	Thermoforming <input type="checkbox"/>	Finishing <input type="checkbox"/>	Rec/Store/Packaging <input type="checkbox"/>	Other <input type="checkbox"/>	Large Fab <input type="checkbox"/>	Composite <input type="checkbox"/>	Supplier <input type="checkbox"/>	
Skid-tube <input type="checkbox"/>	Crosstube <input type="checkbox"/>	Water Jet <input type="checkbox"/>	Engineering <input type="checkbox"/>															
Machining <input type="checkbox"/>	Small Fab <input type="checkbox"/>	Prod. Eng. Coord. <input type="checkbox"/>	Quality <input type="checkbox"/>															
Thermoforming <input type="checkbox"/>	Finishing <input type="checkbox"/>	Rec/Store/Packaging <input type="checkbox"/>	Other <input type="checkbox"/>															
Large Fab <input type="checkbox"/>	Composite <input type="checkbox"/>	Supplier <input type="checkbox"/>																

Root Cause	Date	Step	Qty	Description of work order update or Non-conformance	Initial Chief Eng	Action Description	Sign & Date	Verification	QC Inspector
Doc/Data									
Equip/Tooling									
Operator									
Material									
Setup									
Other									
Process									
Supplier									
Training									
Unapproved									

FAULT CATEGORY

Landing Gear	General	Other	Other
<input type="checkbox"/> Bending	<input type="checkbox"/> Bend	<input type="checkbox"/> Grain	<input type="checkbox"/> Ovalized
<input type="checkbox"/> Centre Not Concentric to O/S	<input type="checkbox"/> BOM/Route	<input type="checkbox"/> Hardware	<input type="checkbox"/> Over/Under tolerance
<input type="checkbox"/> Cracks	<input type="checkbox"/> Broken/Damaged	<input type="checkbox"/> Inspection Incomplete	<input type="checkbox"/> Part Incorrect
<input type="checkbox"/> Crushed/Crimped	<input type="checkbox"/> Burrs	<input type="checkbox"/> Instructions Incomplete/Unclear	<input type="checkbox"/> Part Lost/Missing
<input type="checkbox"/> Cuffs	<input type="checkbox"/> Contamination	<input type="checkbox"/> Maintenance	<input type="checkbox"/> Part Moved
<input type="checkbox"/> Heat Treat	<input type="checkbox"/> Countersink	<input type="checkbox"/> Misabeled	<input type="checkbox"/> Positioned Wrong
<input type="checkbox"/> Inspection Strip in Tube	<input type="checkbox"/> Cut Too Short	<input type="checkbox"/> Misread	<input type="checkbox"/> Power Loss/Surge
<input type="checkbox"/> Ripples in Bend	<input type="checkbox"/> Drill Holes	<input type="checkbox"/> Offset	<input type="checkbox"/> Pressure/Forced
<input type="checkbox"/> Torque Waves in Extrusion	<input type="checkbox"/> Drawing	<input type="checkbox"/> Out of Calibration	<input type="checkbox"/> Temperature/Cure
<input type="checkbox"/> Turning Sequence	<input type="checkbox"/> Finish	<input type="checkbox"/> Out of Sequence	<input type="checkbox"/> Weld
<input type="checkbox"/> Wave/Twist in Tube	<input type="checkbox"/> Folio	<input type="checkbox"/> Outside Dimensions	<input type="checkbox"/> Wrong Stock Pulled
			<input type="checkbox"/> Other

Work Order ID 106848

106848

Page 2

September-11-13 11:47:08 AM

Item ID: 646.3715

Accept

N900040100

Setup Start *NS1*

Revision ID:

Stop *NS2*

Item Name: Strut Doubler

Start Date: 9/23/13

Start Qty: 16.00

16

Cust Item ID:

Required Date: 9/23/13

Req'd Qty: 16.00

16

Customer:

Reference:

Approvals:

Process Plan:

Date:

Tooling:

Date:

Run Start *NR1*

QC:

Date:

SPC (Y/N):

Date:

Stop *NR2*

Sequence ID/
Work Center IDOperation
DescriptionSet Up/
Run Hours

Tool ID

Tool #

Plan
CodeAccept
QtyReject
QtyReject
NumberInsp.
Stamp

130

QC8- Inspect parts - second check

0.00

27
9-89

130

QC

Memo

0.00

Quality Control

140

Outsource process-Anodize per QSI017 4.1.10.1

0.00

140

Outsource4

Memo

0.00

Outsource process - Anodize

Issue P/O to ATG : 21915

1- Black Anodize as per Dwg 646.3700

2- PRIME AS PER DWG, SEE NOTE #2

Certification of Comformity is required

150

Receive & Inspect for Damage & Mat'l Certs

0.00

150

Packaging

Memo

0.00

Packaging

NCR: Yes / No

WORK ORDER NON-CONFORMANCE / UPDATE

DQA: _____ Date: _____

QA Closed: _____ Date: _____

Work Order: _____ Part No. _____ NCR No. _____	DISPOSITION Rework <input type="checkbox"/> Scrap <input type="checkbox"/> Use-as-is <input type="checkbox"/> Work Order Update <input type="checkbox"/>	AGAINST DEPARTMENT/PROCESS <table style="width: 100%;"> <tr> <td>Skid-tube <input type="checkbox"/></td> <td>Crosstube <input type="checkbox"/></td> <td>Water Jet <input type="checkbox"/></td> <td>Engineering <input type="checkbox"/></td> </tr> <tr> <td>Machining <input type="checkbox"/></td> <td>Small Fab <input type="checkbox"/></td> <td>Prod. Eng. Coord. <input type="checkbox"/></td> <td>Quality <input type="checkbox"/></td> </tr> <tr> <td>Thermoforming <input type="checkbox"/></td> <td>Finishing <input type="checkbox"/></td> <td>Rec/Store/Packaging <input type="checkbox"/></td> <td>Other <input type="checkbox"/></td> </tr> <tr> <td>Large Fab <input type="checkbox"/></td> <td>Composite <input type="checkbox"/></td> <td>Supplier <input type="checkbox"/></td> <td></td> </tr> </table>	Skid-tube <input type="checkbox"/>	Crosstube <input type="checkbox"/>	Water Jet <input type="checkbox"/>	Engineering <input type="checkbox"/>	Machining <input type="checkbox"/>	Small Fab <input type="checkbox"/>	Prod. Eng. Coord. <input type="checkbox"/>	Quality <input type="checkbox"/>	Thermoforming <input type="checkbox"/>	Finishing <input type="checkbox"/>	Rec/Store/Packaging <input type="checkbox"/>	Other <input type="checkbox"/>	Large Fab <input type="checkbox"/>	Composite <input type="checkbox"/>	Supplier <input type="checkbox"/>	
Skid-tube <input type="checkbox"/>	Crosstube <input type="checkbox"/>	Water Jet <input type="checkbox"/>	Engineering <input type="checkbox"/>															
Machining <input type="checkbox"/>	Small Fab <input type="checkbox"/>	Prod. Eng. Coord. <input type="checkbox"/>	Quality <input type="checkbox"/>															
Thermoforming <input type="checkbox"/>	Finishing <input type="checkbox"/>	Rec/Store/Packaging <input type="checkbox"/>	Other <input type="checkbox"/>															
Large Fab <input type="checkbox"/>	Composite <input type="checkbox"/>	Supplier <input type="checkbox"/>																

Root Cause	Date	Step	Qty	Description of work order update or Non-conformance	Initial Chief Eng	Action Description	Sign & Date	Verification	QC Inspector
Doc/Data <input type="checkbox"/>									
Equip/Tooling <input type="checkbox"/>									
Operator <input type="checkbox"/>									
Material <input type="checkbox"/>									
Setup <input type="checkbox"/>									
Other <input type="checkbox"/>									
Process <input type="checkbox"/>									
Supplier <input type="checkbox"/>									
Training <input type="checkbox"/>									
Unapproved <input type="checkbox"/>									

FAULT CATEGORY

Landing Gear <input type="checkbox"/> Bending <input type="checkbox"/> Centre Not Concentric to O/S <input type="checkbox"/> Cracks <input type="checkbox"/> Crushed/Crimped <input type="checkbox"/> Cuffs <input type="checkbox"/> Heat Treat <input type="checkbox"/> Inspection Strip in Tube <input type="checkbox"/> Ripples in Bend <input type="checkbox"/> Torque Waves in Extrusion <input type="checkbox"/> Turning Sequence <input type="checkbox"/> Wave/Twist in Tube	General <input type="checkbox"/> Bend <input type="checkbox"/> BOM/Route <input type="checkbox"/> Broken/Damaged <input type="checkbox"/> Burrs <input type="checkbox"/> Contamination <input type="checkbox"/> Countersink <input type="checkbox"/> Cut Too Short <input type="checkbox"/> Drill Holes <input type="checkbox"/> Drawing <input type="checkbox"/> Finish <input type="checkbox"/> Folio	<input type="checkbox"/> Grain <input type="checkbox"/> Hardware <input type="checkbox"/> Inspection Incomplete <input type="checkbox"/> Instructions Incomplete/Unclear <input type="checkbox"/> Maintenance <input type="checkbox"/> Mislabeled <input type="checkbox"/> Misread <input type="checkbox"/> Offset <input type="checkbox"/> Out of Calibration <input type="checkbox"/> Out of Sequence <input type="checkbox"/> Outside Dimensions <input type="checkbox"/> Ovalized <input type="checkbox"/> Over/Under tolerance <input type="checkbox"/> Part Incorrect <input type="checkbox"/> Part Lost/Missing <input type="checkbox"/> Part Moved <input type="checkbox"/> Positioned Wrong <input type="checkbox"/> Power Loss/Surge <input type="checkbox"/> Pressure/Forced <input type="checkbox"/> Temperature/Cure <input type="checkbox"/> Weld <input type="checkbox"/> Wrong Stock Pulled <input type="checkbox"/> Other
---	---	--

Work Order ID 106848

106848

Page 3

September-11-13 11:47:08 AM

Item ID: 646.3715 Accept *N900040100* Setup Start *NS1*
Revision ID: Stop *NS2*
Item Name: Strut Doubler
Start Date: 9/23/13 Start Qty: 16.00 *16* Cust Item ID:
Required Date: 9/23/13 Req'd Qty: 16.00 *16* Customer:
Reference:

Approvals: Process Plan: Date: Tooling: Date: Run Start *NR1*
QC: Date: SPC (Y/N): Date: Stop *NR2*

Sequence ID/ Work Center ID	Operation Description	Set Up/ Run Hours	Tool ID	Tool #	Plan Code	Accept Qty	Reject Qty	Reject Number	Insp. Stamp
--------------------------------	--------------------------	----------------------	---------	--------	--------------	---------------	---------------	------------------	----------------

160

160

QC

Quality Control

QC5- Inspect part completeness to step on W/O

Memo

0.00

0.00

Smb
13/12/02

16

190

190

Packaging

Packaging

Identify as per dwg & Stock Location: 81523A 0.00

Memo

***IDENTIFY AS PER APICAL MPP-120 BY STAMPING THE P# AND
REV***

0.00

Box CU 13-12-3

200

200

QC

Quality Control

QC21- Final Inspection - Work Order Release

Memo

0.00

0.00

13/12/03
mf
13-12-03

NCR: Yes / No

WORK ORDER NON-CONFORMANCE / UPDATE

DQA: _____ Date: _____

QA Closed: _____ Date: _____

Work Order: _____ Part No. _____ NCR No. _____	DISPOSITION Rework <input type="checkbox"/> Scrap <input type="checkbox"/> Use-as-is <input type="checkbox"/> Work Order Update <input type="checkbox"/>	AGAINST DEPARTMENT/PROCESS <table style="width: 100%; border: none;"> <tr> <td style="width: 25%;">Skid-tube <input type="checkbox"/></td> <td style="width: 25%;">Crosstube <input type="checkbox"/></td> <td style="width: 25%;">Water Jet <input type="checkbox"/></td> <td style="width: 25%;">Engineering <input type="checkbox"/></td> </tr> <tr> <td>Machining <input type="checkbox"/></td> <td>Small Fab <input type="checkbox"/></td> <td>Prod. Eng. Coord. <input type="checkbox"/></td> <td>Quality <input type="checkbox"/></td> </tr> <tr> <td>Thermoforming <input type="checkbox"/></td> <td>Finishing <input type="checkbox"/></td> <td>Rec/Store/Packaging <input type="checkbox"/></td> <td>Other <input type="checkbox"/></td> </tr> <tr> <td>Large Fab <input type="checkbox"/></td> <td>Composite <input type="checkbox"/></td> <td>Supplier <input type="checkbox"/></td> <td></td> </tr> </table>	Skid-tube <input type="checkbox"/>	Crosstube <input type="checkbox"/>	Water Jet <input type="checkbox"/>	Engineering <input type="checkbox"/>	Machining <input type="checkbox"/>	Small Fab <input type="checkbox"/>	Prod. Eng. Coord. <input type="checkbox"/>	Quality <input type="checkbox"/>	Thermoforming <input type="checkbox"/>	Finishing <input type="checkbox"/>	Rec/Store/Packaging <input type="checkbox"/>	Other <input type="checkbox"/>	Large Fab <input type="checkbox"/>	Composite <input type="checkbox"/>	Supplier <input type="checkbox"/>	
Skid-tube <input type="checkbox"/>	Crosstube <input type="checkbox"/>	Water Jet <input type="checkbox"/>	Engineering <input type="checkbox"/>															
Machining <input type="checkbox"/>	Small Fab <input type="checkbox"/>	Prod. Eng. Coord. <input type="checkbox"/>	Quality <input type="checkbox"/>															
Thermoforming <input type="checkbox"/>	Finishing <input type="checkbox"/>	Rec/Store/Packaging <input type="checkbox"/>	Other <input type="checkbox"/>															
Large Fab <input type="checkbox"/>	Composite <input type="checkbox"/>	Supplier <input type="checkbox"/>																

Root Cause	Date	Step	Qty	Description of work order update or Non-conformance	Initial Chief Eng	Action Description	Sign & Date	Verification	QC Inspector
Doc/Data									
Equip/Tooling									
Operator									
Material									
Setup									
Other									
Process									
Supplier									
Training									
Unapproved									

FAULT CATEGORY

Landing Gear	General	Other	Other
<input type="checkbox"/> Bending	<input type="checkbox"/> Bend	<input type="checkbox"/> Grain	<input type="checkbox"/> Ovalized
<input type="checkbox"/> Centre Not Concentric to O/S	<input type="checkbox"/> BOM/Route	<input type="checkbox"/> Hardware	<input type="checkbox"/> Over/Under tolerance
<input type="checkbox"/> Cracks	<input type="checkbox"/> Broken/Damaged	<input type="checkbox"/> Inspection Incomplete	<input type="checkbox"/> Part Incorrect
<input type="checkbox"/> Crushed/Crimped	<input type="checkbox"/> Burrs	<input type="checkbox"/> Instructions Incomplete/Unclear	<input type="checkbox"/> Part Lost/Missing
<input type="checkbox"/> Cuffs	<input type="checkbox"/> Contamination	<input type="checkbox"/> Maintenance	<input type="checkbox"/> Part Moved
<input type="checkbox"/> Heat Treat	<input type="checkbox"/> Countersink	<input type="checkbox"/> Mislabeled	<input type="checkbox"/> Positioned Wrong
<input type="checkbox"/> Inspection Strip in Tube	<input type="checkbox"/> Cut Too Short	<input type="checkbox"/> Misread	<input type="checkbox"/> Power Loss/Surge
<input type="checkbox"/> Ripples in Bend	<input type="checkbox"/> Drill Holes	<input type="checkbox"/> Offset	<input type="checkbox"/> Pressure/Forced
<input type="checkbox"/> Torque Waves in Extrusion	<input type="checkbox"/> Drawing	<input type="checkbox"/> Out of Calibration	<input type="checkbox"/> Temperature/Cure
<input type="checkbox"/> Turning Sequence	<input type="checkbox"/> Finish	<input type="checkbox"/> Out of Sequence	<input type="checkbox"/> Weld
<input type="checkbox"/> Wave/Twist in Tube	<input type="checkbox"/> Folio	<input type="checkbox"/> Outside Dimensions	<input type="checkbox"/> Wrong Stock Pulled
			<input type="checkbox"/> Other

Picklist Print

September-11-13 11:47:08 AM

Page 1/1

Work Order ID: 106848

Parent Item: 646.3715

Parent Item Name: Strut Doubler

Start Date: 9/23/13

Required Date: 9/23/13

Start Qty: 16.00

Required Qty: 16.00

Comments: IPP REV:A 12.10.22 NEW ISSUE DD VERF:JLM

Component Item ID/ Item Name	Replacement Item ID	Mfg/ Purch	Bin Item	Primary Location	Last Location	Route Seq ID	Unit of Measure	Qty on Hand	Qty per Kit	Total Qty	Qty Issued	Date Issued	Status
---------------------------------	------------------------	---------------	-------------	---------------------	------------------	-----------------	--------------------	----------------	-------------	--------------	---------------	----------------	--------

M6061T6S.040
6061-T6 .040 Sheet

Purchased No

110 sf 264.5670 0.0434

~~0.7309472~~

Ac 13.11.02

Location

Loc Qty

Loc Code

MAT021

264.567

m126350

264.567

126350 → 1730

NCR: Yes / No

WORK ORDER NON-CONFORMANCE / UPDATE

DQA: _____ Date: _____

QA Closed: _____ Date: _____

Work Order: _____ Part No. _____ NCR No. _____	DISPOSITION Rework <input type="checkbox"/> Scrap <input type="checkbox"/> Use-as-is <input type="checkbox"/> Work Order Update <input type="checkbox"/>	AGAINST DEPARTMENT/PROCESS <table style="width:100%; border: none;"> <tr> <td style="width:25%;">Skid-tube <input type="checkbox"/></td> <td style="width:25%;">Crosstube <input type="checkbox"/></td> <td style="width:25%;">Water Jet <input type="checkbox"/></td> <td style="width:25%;">Engineering <input type="checkbox"/></td> </tr> <tr> <td>Machining <input type="checkbox"/></td> <td>Small Fab <input type="checkbox"/></td> <td>Prod. Eng. Coord. <input type="checkbox"/></td> <td>Quality <input type="checkbox"/></td> </tr> <tr> <td>Thermoforming <input type="checkbox"/></td> <td>Finishing <input type="checkbox"/></td> <td>Rec/Store/Packaging <input type="checkbox"/></td> <td>Other <input type="checkbox"/></td> </tr> <tr> <td>Large Fab <input type="checkbox"/></td> <td>Composite <input type="checkbox"/></td> <td>Supplier <input type="checkbox"/></td> <td></td> </tr> </table>	Skid-tube <input type="checkbox"/>	Crosstube <input type="checkbox"/>	Water Jet <input type="checkbox"/>	Engineering <input type="checkbox"/>	Machining <input type="checkbox"/>	Small Fab <input type="checkbox"/>	Prod. Eng. Coord. <input type="checkbox"/>	Quality <input type="checkbox"/>	Thermoforming <input type="checkbox"/>	Finishing <input type="checkbox"/>	Rec/Store/Packaging <input type="checkbox"/>	Other <input type="checkbox"/>	Large Fab <input type="checkbox"/>	Composite <input type="checkbox"/>	Supplier <input type="checkbox"/>	
Skid-tube <input type="checkbox"/>	Crosstube <input type="checkbox"/>	Water Jet <input type="checkbox"/>	Engineering <input type="checkbox"/>															
Machining <input type="checkbox"/>	Small Fab <input type="checkbox"/>	Prod. Eng. Coord. <input type="checkbox"/>	Quality <input type="checkbox"/>															
Thermoforming <input type="checkbox"/>	Finishing <input type="checkbox"/>	Rec/Store/Packaging <input type="checkbox"/>	Other <input type="checkbox"/>															
Large Fab <input type="checkbox"/>	Composite <input type="checkbox"/>	Supplier <input type="checkbox"/>																

Root Cause	Date	Step	Qty	Description of work order update or Non-conformance	Initial Chief Eng	Action Description	Sign & Date	Verification	QC Inspector
Doc/Data <input type="checkbox"/>									
Equip/Tooling <input type="checkbox"/>									
Operator <input type="checkbox"/>									
Material <input type="checkbox"/>									
Setup <input type="checkbox"/>									
Other <input type="checkbox"/>									
Process <input type="checkbox"/>									
Supplier <input type="checkbox"/>									
Training <input type="checkbox"/>									
Unapproved <input type="checkbox"/>									

FAULT CATEGORY

Landing Gear <input type="checkbox"/> Bending <input type="checkbox"/> Centre Not Concentric to O/S <input type="checkbox"/> Cracks <input type="checkbox"/> Crushed/Crimped <input type="checkbox"/> Cuffs <input type="checkbox"/> Heat Treat <input type="checkbox"/> Inspection Strip in Tube <input type="checkbox"/> Ripples in Bend <input type="checkbox"/> Torque Waves in Extrusion <input type="checkbox"/> Turning Sequence <input type="checkbox"/> Wave/Twist in Tube	General <input type="checkbox"/> Bend <input type="checkbox"/> BOM/Route <input type="checkbox"/> Broken/Damaged <input type="checkbox"/> Burrs <input type="checkbox"/> Contamination <input type="checkbox"/> Countersink <input type="checkbox"/> Cut Too Short <input type="checkbox"/> Drill Holes <input type="checkbox"/> Drawing <input type="checkbox"/> Finish <input type="checkbox"/> Folio	<input type="checkbox"/> Grain <input type="checkbox"/> Hardware <input type="checkbox"/> Inspection Incomplete <input type="checkbox"/> Instructions Incomplete/Unclear <input type="checkbox"/> Maintenance <input type="checkbox"/> Mislabeled <input type="checkbox"/> Misread <input type="checkbox"/> Offset <input type="checkbox"/> Out of Calibration <input type="checkbox"/> Out of Sequence <input type="checkbox"/> Outside Dimensions
		<input type="checkbox"/> Ovalized <input type="checkbox"/> Over/Under tolerance <input type="checkbox"/> Part Incorrect <input type="checkbox"/> Part Lost/Missing <input type="checkbox"/> Part Moved <input type="checkbox"/> Positioned Wrong <input type="checkbox"/> Power Loss/Surge
		<input type="checkbox"/> Pressure/Forced <input type="checkbox"/> Temperature/Cure <input type="checkbox"/> Weld <input type="checkbox"/> Wrong Stock Pulled <input type="checkbox"/> Other _____

FIRST ARTICLE INSPECTION CHECKLIST

~~DAS~~

27

Revised by:


APICAL INDUSTRIES, INC.	ENGINEERING CHANGE NOTICE NO. 03702				SHEET 1 OF 2	
	DWG NO. 646.3700	REV: A	PREPARED BY B. PETERS	DATE: 11/15/12	EFFECT ON DWG <input type="checkbox"/> INC. <input checked="" type="checkbox"/> UNINC.	
	DWG TITLE: SHEETMETAL					
	APPROVED BY: ENGR <i>[Signature]</i>	MFG <i>[Signature]</i>	QC <i>[Signature]</i>	EFF: NEXT ORDER		
TRANSACTION CODES (TC): A-ADD C-CREATE R-REVISE D-DELETE	REASON: ADDED ALTERNATE MATERIAL AND REVISED REFERENCE DIMENSIONS				EOR: D-12-010	

SHEET 1, ZONE A2 IS:

IS

⚠ PRIMARY MATERIAL: ALUMINUM 6061-T6 PER AMS-QQ-A-250/11
ALTERNATE MATERIAL: SS 17-4 PH PER AMS 5604

IS

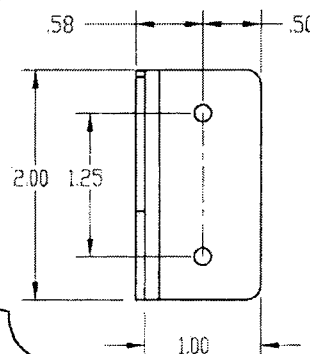


SHEET 7, ZONE B1 IS:


106848 MLJ
13-09-12

F/N	TC	PART NUMBER	QTY	DESCRIPTION	MATERIAL	SPECIFICATION
DOCUMENTS EFFECTED:					CHANGE CATEGORY	DER REVIEW REQUIRED
<input type="checkbox"/> RFMS <input type="checkbox"/> MDL <input type="checkbox"/> INSTALL INSTRUC <input type="checkbox"/> ICA <input type="checkbox"/> BOM					<input type="checkbox"/> MAJOR <input checked="" type="checkbox"/> MINOR	<input type="checkbox"/> YES <input checked="" type="checkbox"/> NO


106848

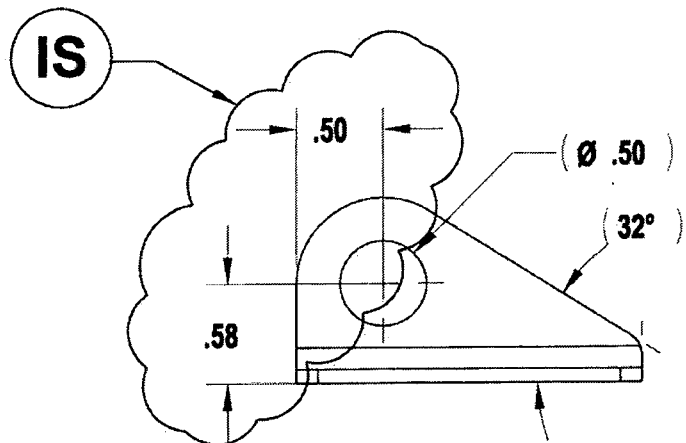

SHEET 7, ZONE C4 IS:

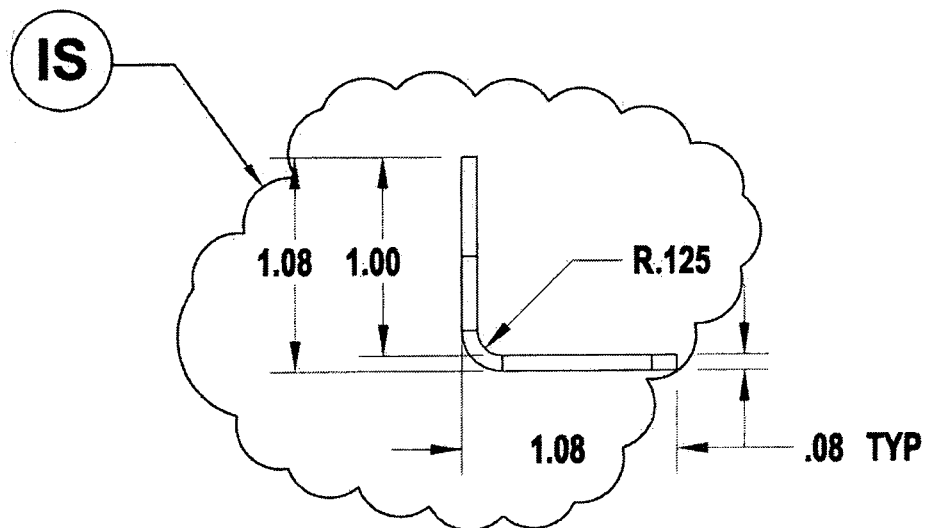

SHEET 7, ZONE D1 IS:

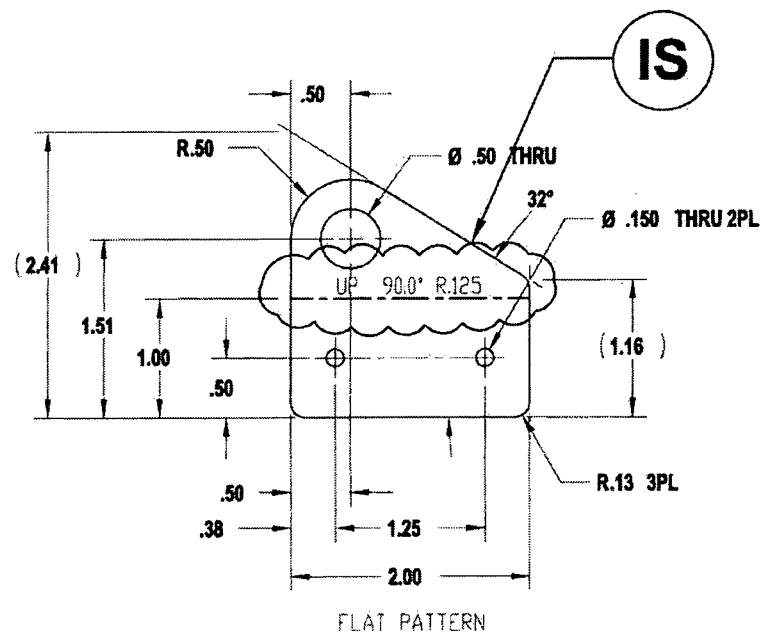

SHEET 7, ZONE B7 IS:

F/N	T/C	PART NUMBER	QTY	DESCRIPTION	MATERIAL/SPECIFICATION
-----	-----	-------------	-----	-------------	------------------------


106848

THE INFORMATION CONTAINED IN THIS DRAWING IS THE SOLE PROPERTY OF APICAL INDUSTRIES AND REPRODUCTION IN PART OR WHOLE WITHOUT THE WRITTEN PERMISSION OF APICAL INDUSTRIES IS PROHIBITED.

REV.	DESCRIPTION	DATE	APPROVED
A	INCORPORATED ECN(S)	01/08/01	REV 25

NOTES:


- 1 MATERIAL: ALUMINUM 6061-T6 PER AMS-QQ-A-250/11
- 2 FINISH: HARD ANODIZE IAW MIL-A-8625 TYPE III, CLASS 2, COLOR BLACK; CARDINAL 4860-50 PRETREATMENT PRIMER IAW MIL-P-23377J TYPE I CLASS N
- 3 MATERIAL: 17-4 PH AMS 5604, CONDITION H900
- 4 FINISH: PRIME IAW MIL-P-23377J TYPE I CLASS N
5. DEBURR AND BREAK ALL SHARP EDGES
6. IDENTIFY IAW MPP-120

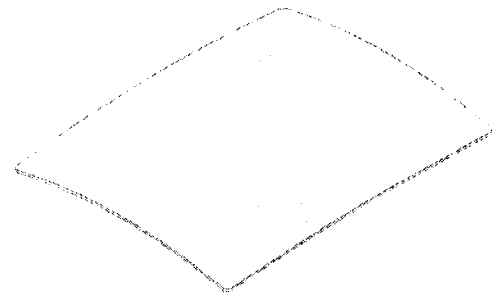

646.3710

UNINCORPORATED ECN(s)

03702

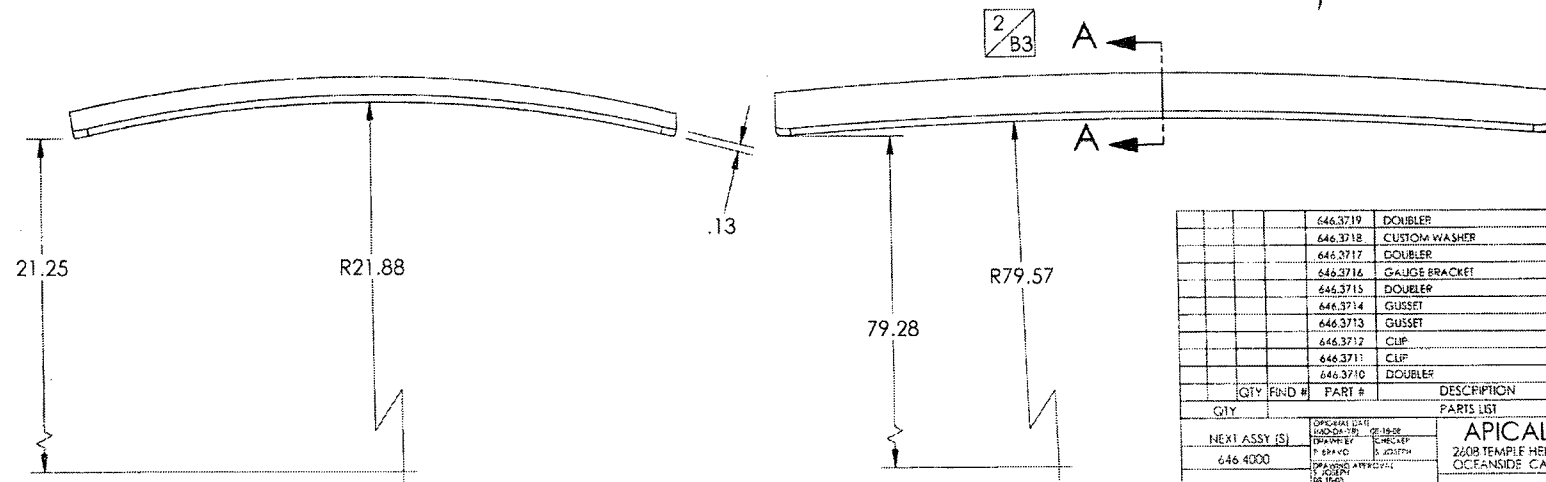

QTY	FIND #	PART #	DESCRIPTION	MATL	SPEC.
		646.3719	DOUBLER		
		646.3718	CUSTOM WASHER		
		646.3717	DOUBLER		
		646.3716	GAUGE BRACKET		
		646.3715	DOUBLER		
		646.3714	GUSSET		
		646.3713	GUSSET		
		646.3712	CLIP		
		646.3711	CLIP		
		646.3710	DOUBLER		


QTY	ASSY (S)	DESCRIPTION	MATL	SPEC.
	646 4000	DOUBLER		

OPERATOR DATE	01/08/01	01/08/01
DESIGNED BY	D. JOSEPH	D. JOSEPH
DRAWING APPROVED		
DATE	01/08/01	01/08/01
SCALE	1" = 1"	1" = 1"

APICAL INDUSTRIES	
2608 TEMPLE HEIGHTS DR.	
OCEANSIDE CA. 92056-3512 (760) 724-5300	
SHEETMETAL	
TITLE	CLUSE COON
ENG. NO.	646.3700
SCALE	NONE
SHEET	1 OF 9


100848

THE INFORMATION CONTAINED IN THIS DRAWING IS THE SOLE PROPERTY OF APICAL INDUSTRIES AND REPRODUCTION IN PART OR WHOLE WITHOUT THE WRITTEN PERMISSION OF APICAL INDUSTRIES IS PROHIBITED.

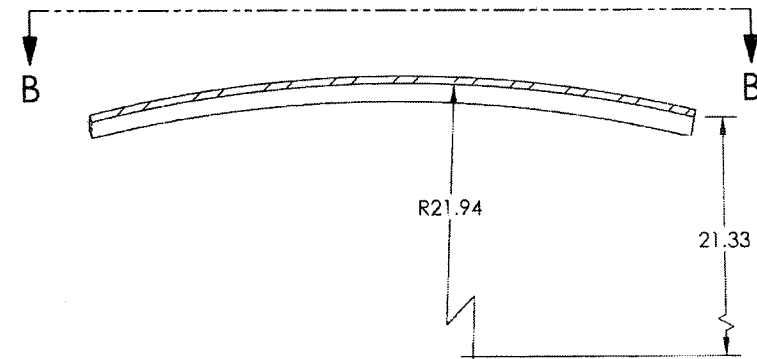

SECTION A-A

1/C6

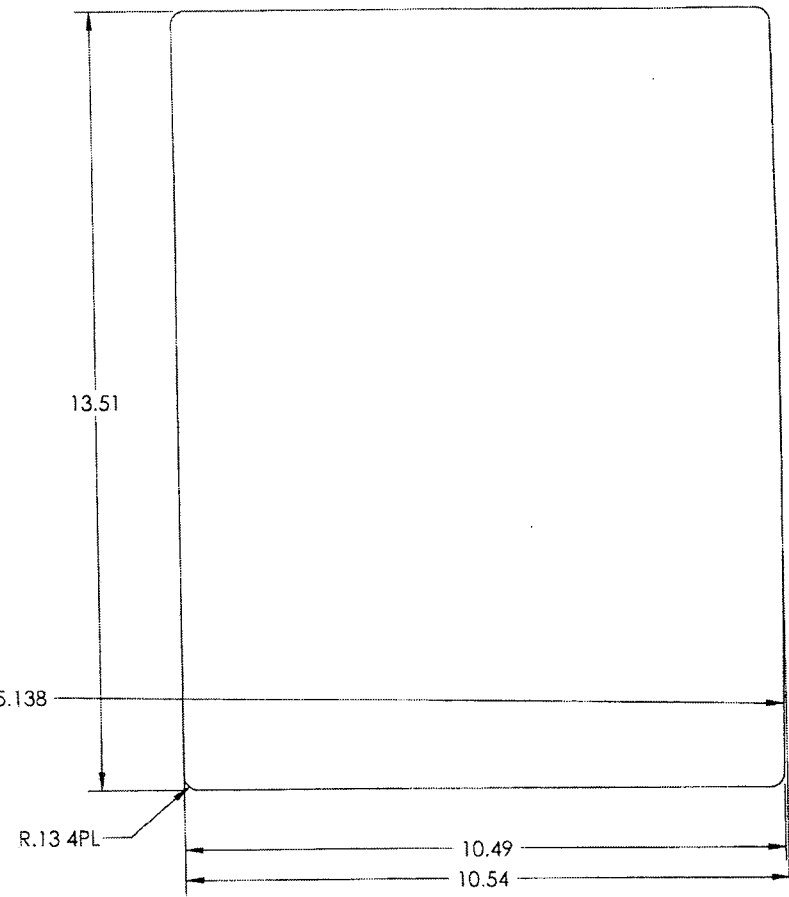



SECTION B-B

<small> COMPANY: APICAL INDUSTRIES DRAWN BY: J. JOSEPH P. 000000 CHECKED BY: J. JOSEPH DATE: 06/12/04 CONTRACT: 100 </small>		APICAL INDUSTRIES <small>2608 TEMPLE HEIGHTS DR. OCEANSIDE, CA. 92056-3512 (760) 724-5300</small>	
<small> UNLESS OTHERWISE SPECIFIED DIMENSIONS ARE IN INCHES DECIMALS USE 3 PLACE DECIMALS ±.01 4 PLACE DECIMALS ±.001 FRACTIONS ± 1/16" </small>		<small>SHEET</small> 8 <small>PAGE CODE</small> 07M16 <small>DWG. NO.</small> 646.3700	<small>REV.</small> A
<small>SCALE</small> NONE		<small>SHEET</small> 2 OF 9	




100848

1: THE INFORMATION CONTAINED IN THIS DRAWING IS THE SOLE PROPERTY OF APICAL INDUSTRIES. ANY REPRODUCTION IN PART OR WHOLE WITHOUT THE WRITTEN PERMISSION OF APICAL INDUSTRIES IS PROHIBITED.

REVISIONS			
REV.	DESCRIPTION	DATE	APPROVED

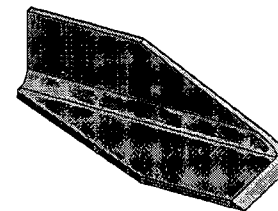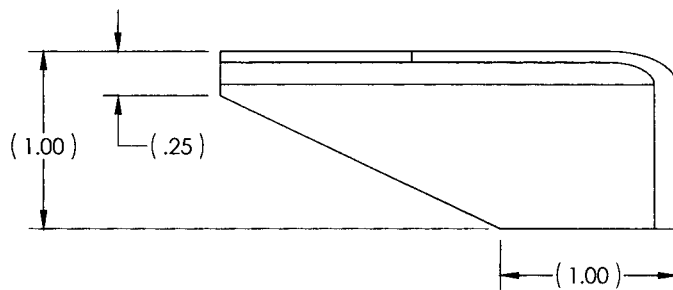

646.3711 SHOWN
646.3712 OPPOSITE

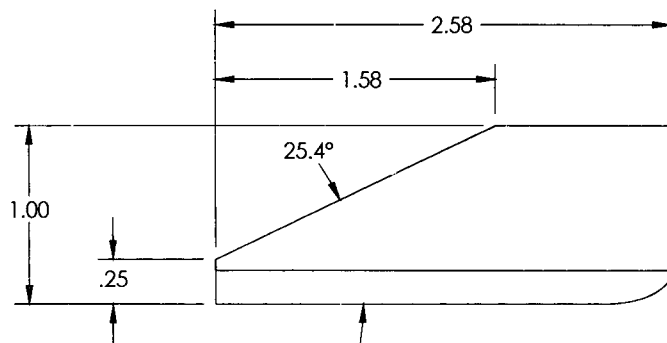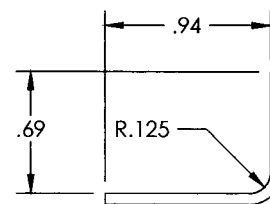
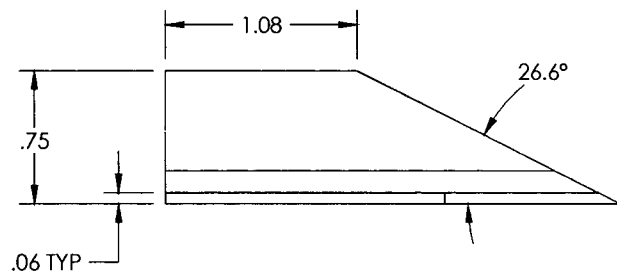


NEXT ASSY (S)	ORIGINAL DATE 08-18-06	APICAL INDUSTRIES	
	DRAWN BY P. BRAVO	2608 TEMPLE HEIGHTS DR. OCEANSIDE, CA. 92056-3512 (760)724-5300	
	CHECKED BY S. JOSEPH	SHEETMETAL	
	DRAWING APPROVAL S. JOSEPH 08-18-06 CONTRACT NO.		
UNLESS OTHERWISE SPECIFIED DIMENSIONS ARE IN INCHES TOLERANCES ARE: 2 PLACE DECIMALS ±.01 3 PLACE DECIMALS ±.005 ANGLES ±.3°		SHEET B	REV. A
SCALE: NONE		SHEET 3 OF 9	


106848

THE INFORMATION CONTAINED IN THIS DRAWING IS THE SOLE PROPERTY OF APICAL INDUSTRIES AND REPRODUCTION IN PART OR WHOLE WITHOUT THE WRITTEN PERMISSION OF APICAL INDUSTRIES IS PROHIBITED.




REV	DESCRIPTION	DATE	APPROVED

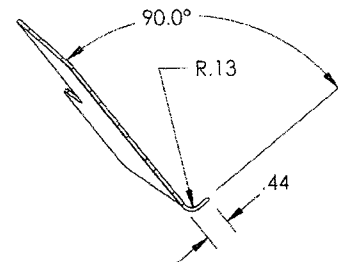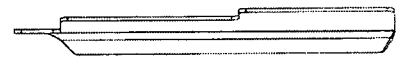

SECTION C-C

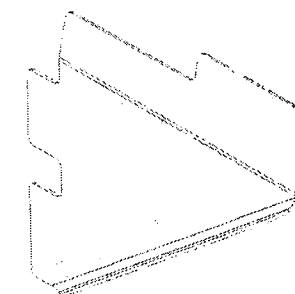

646.3713

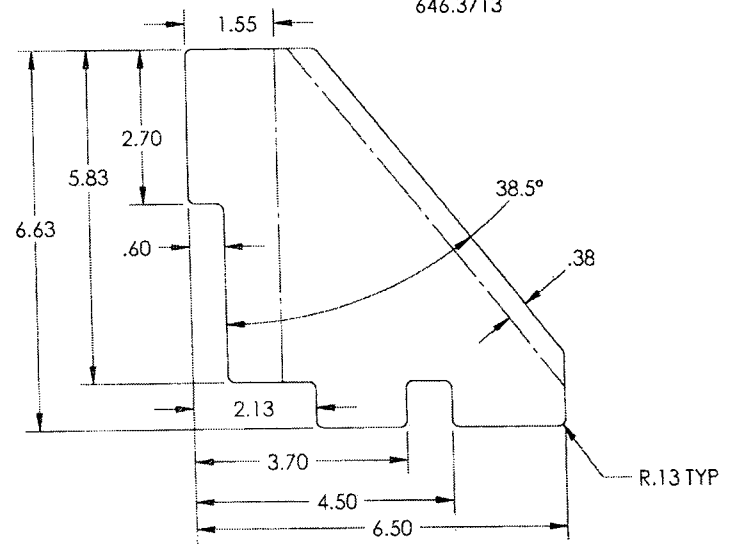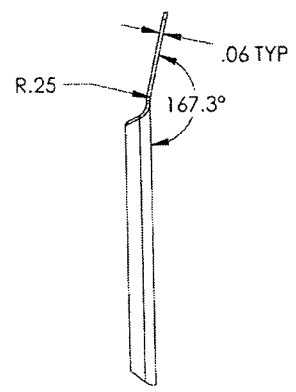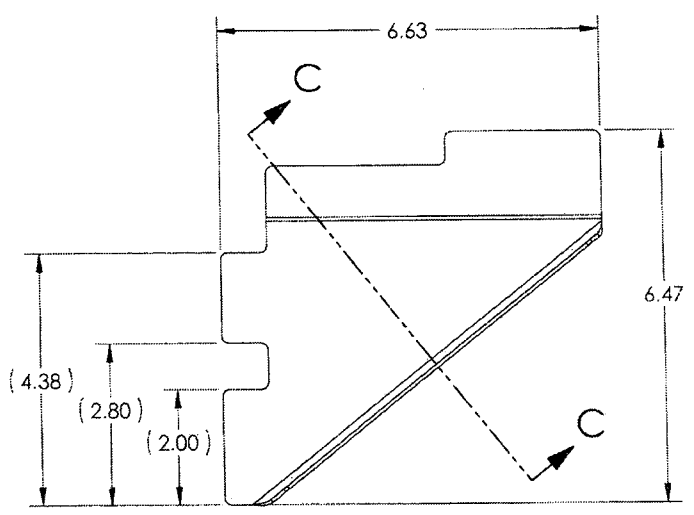

FLAT PATTERN

NEXT ASSY IS:	DESIGNED BY	DATE	APICAL INDUSTRIES 2635 TEMPLE HEIGHTS DR. OCEANSIDE, CA. 92056-3512 (760)724-5300	
	DRAWN BY	DATE		
	CHECKED BY	DATE		
	CONTRACT NO.	DATE		
UNLESS OTHERWISE SPECIFIED:			SHEET CODE	DWG NO.
DIMENSIONS ARE IN INCHES			B	07M26
TOLERANCES ARE:			SCALE	1:1
FRACTIONS 1/16" TO 1/8"				
DECIMALS .0005 TO .005"				
ANGLES .5° TO 90°				

SHEETMETAL


646.3700

SHEET 4 OF 9


106848

THE INFORMATION CONTAINED IN THIS DRAWING IS THE SOLE PROPERTY OF APICAL INDUSTRIES AND REPRODUCTION IN PART OR WHOLE WITHOUT THE WRITTEN PERMISSION OF APICAL INDUSTRIES IS PROHIBITED




REV	DESCRIPTION	DATE	APPROVED

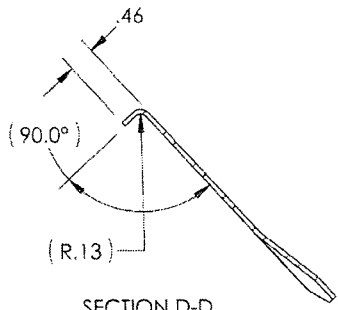

SECTION D-D

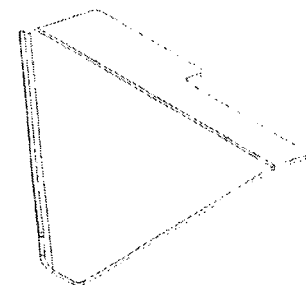

646.3714

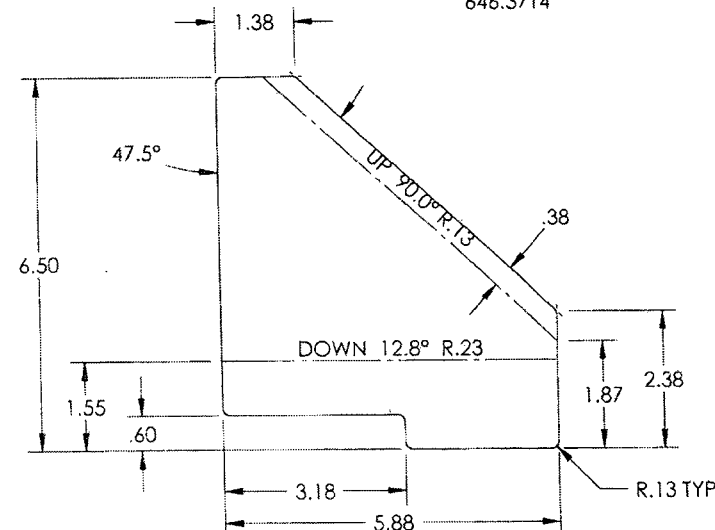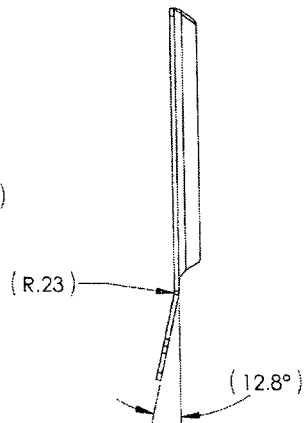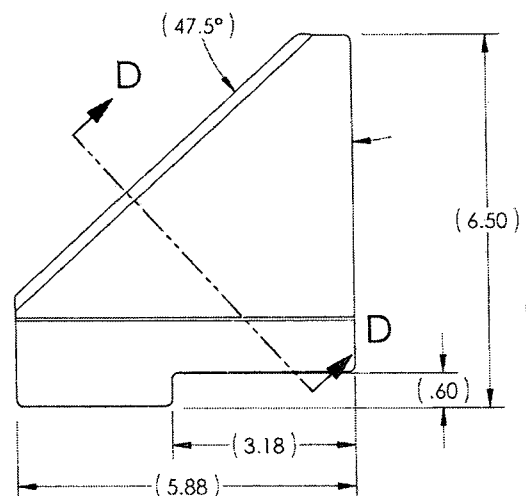



FLAT PATTERN

ORIGINAL DATE 05/01/03 DRAWN BY J. JOHNSON CHECKED BY J. JOHNSON APPROVED BY J. JOHNSON DATE 05/01/03	APICAL INDUSTRIES 2608 TEMPLE HEIGHTS DR. OCEANSIDE, CA. 92056-3512 (760) 724-5300
SHEET METAL SPECIFICATIONS ARE PER AIAA 10-1-1995 DIMENSIONS ARE IN INCHES UNLESS OTHERWISE SPECIFIED DECIMALS TO 2 PLACES ANGLES TO 1°	SHEETMETAL 646.3700 SCALE: NONE SHEET 5 OF 7

106848

THE INFORMATION CONTAINED IN THIS DRAWING IS THE SOLE PROPERTY OF APICAL INDUSTRIES. ANY REPRODUCTION IN PART OR WHOLE WITHOUT THE WRITTEN PERMISSION OF APICAL INDUSTRIES IS PROHIBITED.

REVISION		DATE	APPROVED
REV	DESCRIPTION		

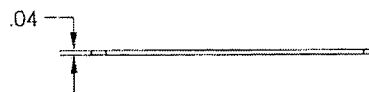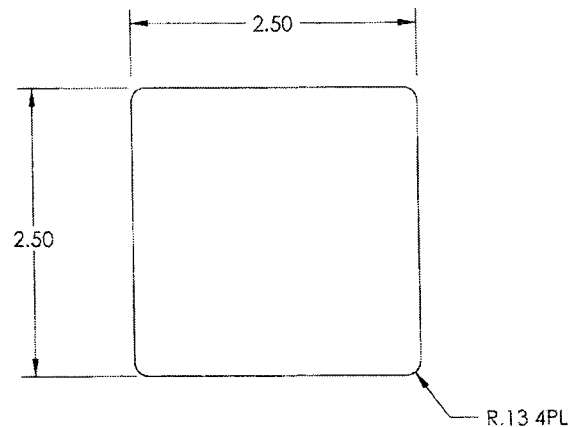



646.3715

NEXT ASSY IS	ORIGINAL DATE	06-18-08	APICAL INDUSTRIES 2608 TEMPLE HEIGHTS DR. OCEANSIDE, CA. 92056-3512 (760)724-1300	
	DESIGNED BY	JOSEPH		
	DRAWN BY	JOSEPH	SHEETMETAL	
	DRAWING APPROVAL			
	DATE	06-18-08	REF	CAGE CODE
	DATE	06-18-08	B	07M26
	UNLESS OTHERWISE SPECIFIED		QTY	646.3700
	DIMENSIONS ARE IN INCHES		SCALE	1:1
	DECIMALS ARE			
	THREE DECIMALS ± .01			
	FOUR DECIMALS ± .005			
	ANGLES ± .5°			



106848

THE INFORMATION CONTAINED IN THIS DRAWING IS THE SOLE PROPERTY OF APICAL INDUSTRIES. ANY REPRODUCTION IN PART OR WHOLE WITHOUT THE WRITTEN PERMISSION OF APICAL INDUSTRIES IS PROHIBITED.

REV	DESCRIPTION	DATE	APPROVED

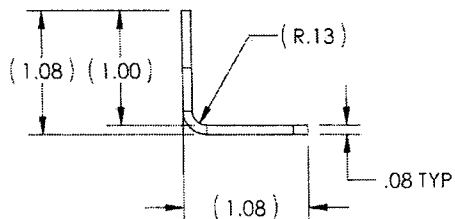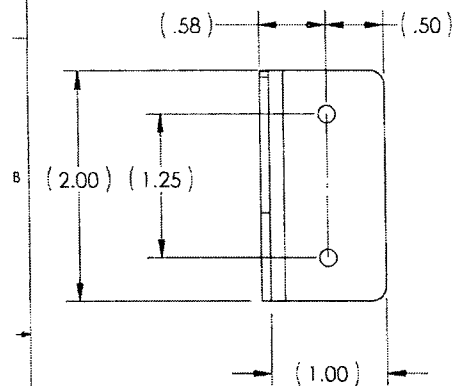

646.3716

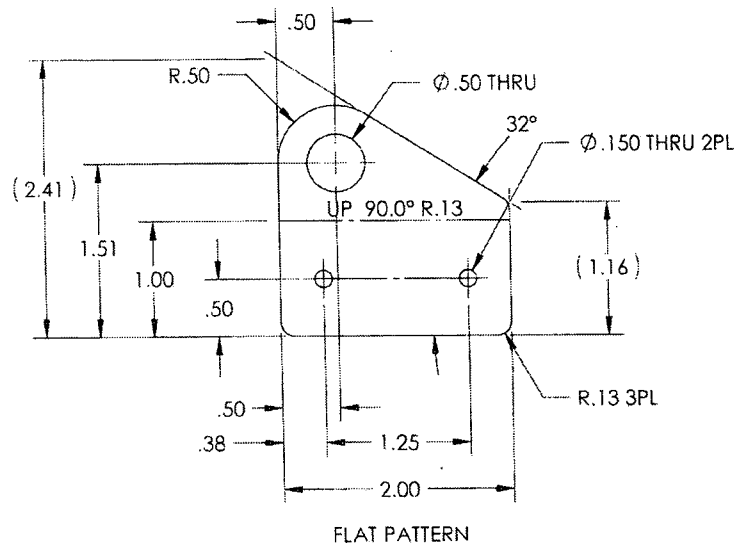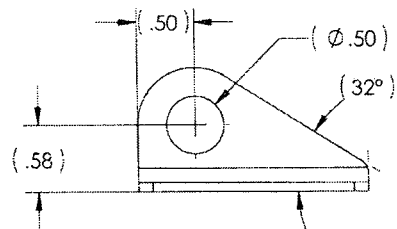


FLAT PATTERN

NEXT ASSY (S)	DESIGNED BY	DATE	08-18-09
	DESIGNED BY	DATE	08-18-09
	DESIGNED BY	DATE	08-18-09
	DESIGNED BY	DATE	08-18-09
UNLESS OTHERWISE SPECIFIED	ALL DIMENSIONS ARE IN INCHES	APICAL INDUSTRIES 2608 TEMPLE HEIGHTS DR. OCEANSIDE, CA. 92056-3512 (760)724-5300	
	ALL DIMENSIONS ARE IN INCHES		
	ALL DIMENSIONS ARE IN INCHES		
	ALL DIMENSIONS ARE IN INCHES		
SCALE: 1:1		DWG. NO.	646.3700
SHEET 1 OF 1		SHEET 1 OF 1	

106848

THE INFORMATION CONTAINED IN THIS DRAWING IS THE SOLE PROPERTY OF APICAL INDUSTRIES. ANY REPRODUCTION IN PART OR WHOLE WITHOUT THE WRITTEN PERMISSION OF APICAL INDUSTRIES IS PROHIBITED.

REV		DESCRIPTION	DATE	APPROVED


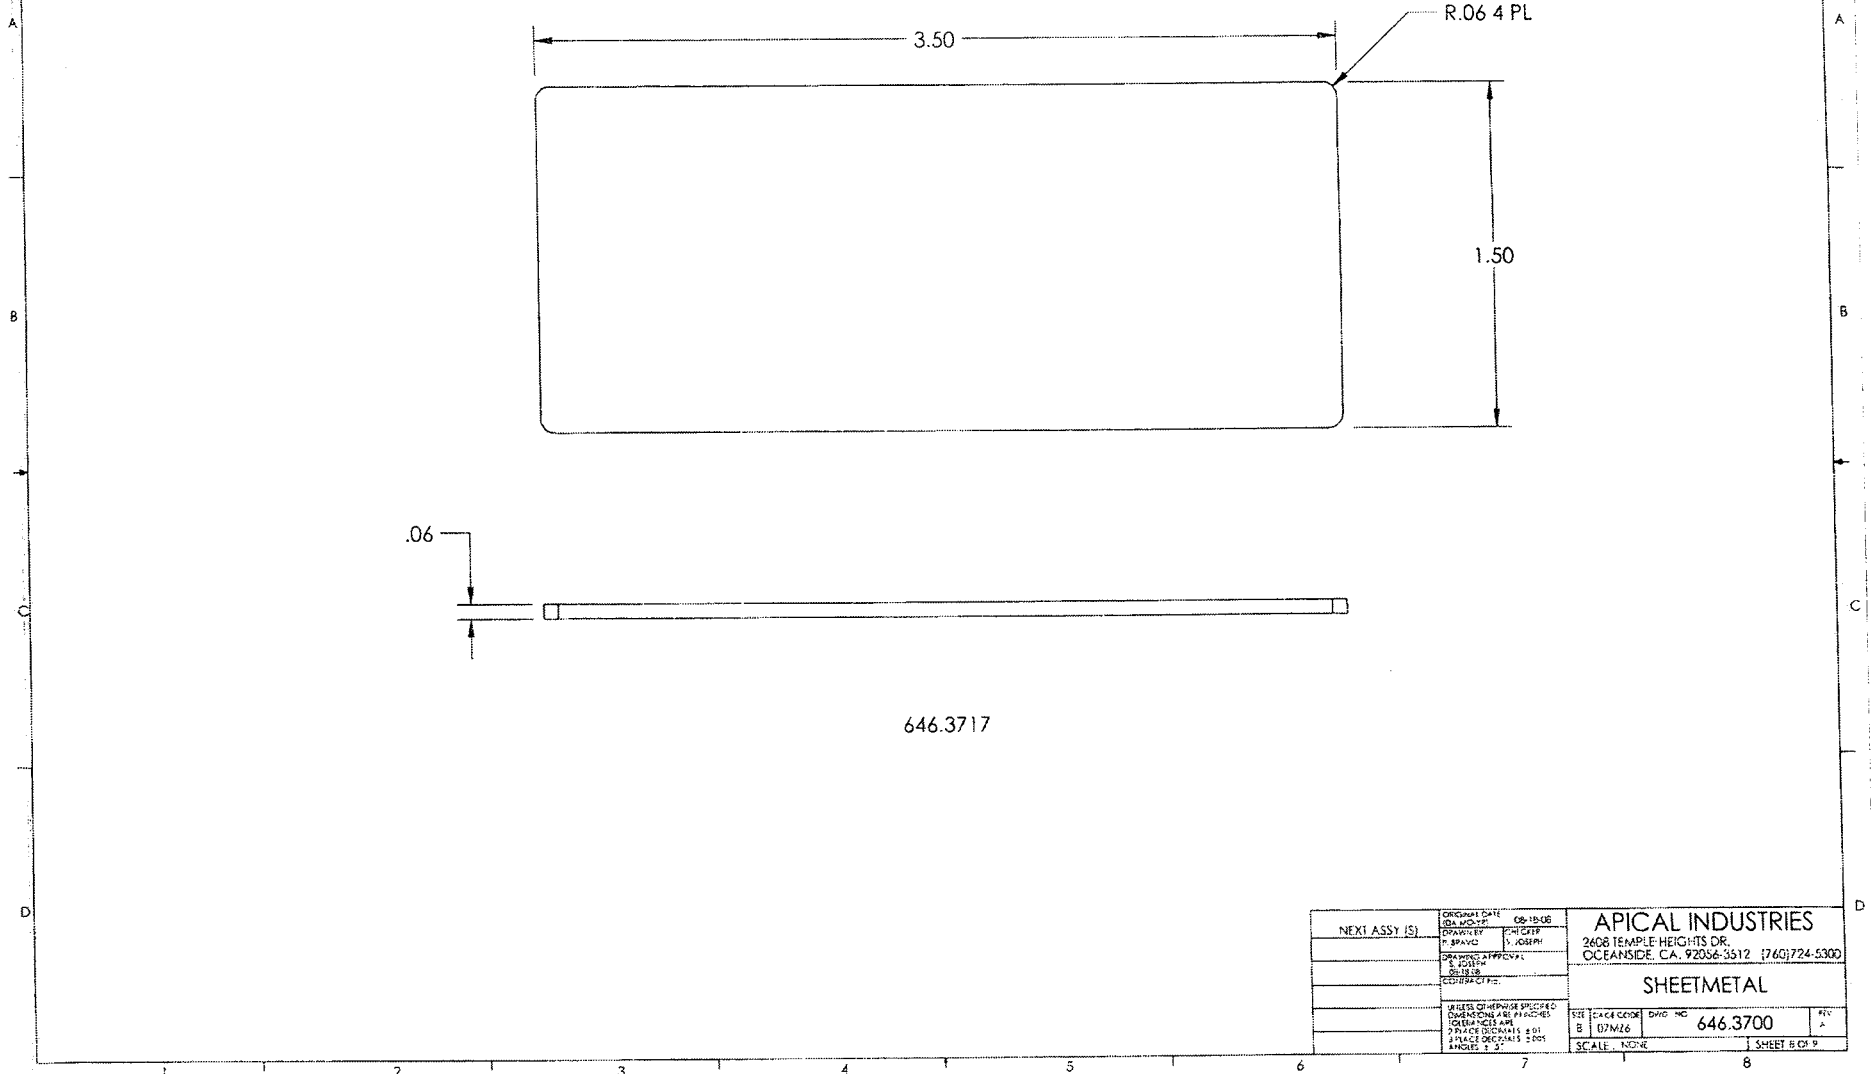


NEXT ASSY (S)	ORIGINAL DATE	06-18-08	APICAL INDUSTRIES 2608 TEMPLE HEIGHTS DR. OCEANSIDE, CA. 92056-3512 (760) 724-5300	
	DATE MODIFIED	06-18-08		
	DRAWN BY	J. JOSEPH	SHEETMETAL	
	CHECKED BY	J. JOSEPH		
	DRAWING APPROVAL		SIZE	CAGE CODE
			B	D7M26
			DWG NO	646.3700
			SCALE	NONE
				SHEET B OF 9


106848

THE INFORMATION CONTAINED IN THIS DRAWING IS THE SOLE PROPERTY OF APICAL INDUSTRIES. ANY REPRODUCTION IN PART OR WHOLE WITHOUT THE WRITTEN PERMISSION OF APICAL INDUSTRIES IS PROHIBITED.

REV	DESCRIPTION	DATE	APPROVED

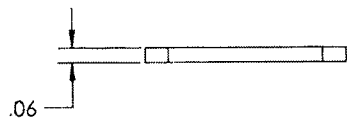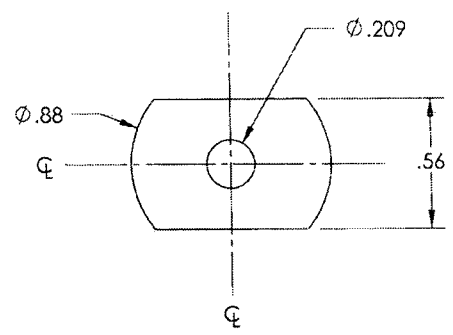

646.3718

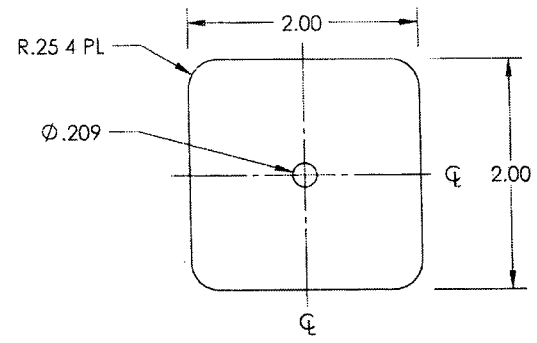

646.3719

NEXT ASSY (S)	CONTRACT DATE	08-18-08	APICAL INDUSTRIES 2608 TEMPLE HEIGHTS DR. OCEANSIDE, CA. 92056-3512 (760)724-5300
	DESIGNED BY	J. JOSEPH	
	DRAWN BY	J. JOSEPH	
	CHECKED BY	J. JOSEPH	
UNLESS OTHERWISE SPECIFIED DIMENSIONS ARE IN INCHES TOLERANCES ARE: FRACTIONS DECIMALS ANGLES .0005 .0001 .0001			SHEET CODE: 646.3700 SCALE: NONE SHEET 9 OF 9



A.T.G. Industries Inc.
731, rue Industrielle Rd.
PLATING DEPARTMENT
Rockland, On K4K 1T2
Canada
Ph: (613) 446-4544
Fax: (613) 446-4556

Pack List

Number: 62753

Date: 22-Nov-13

To

DART AEROSPACE LTD
1270 ABERDEEN ST.
HAWKESBURY, ON K6A 1K7
Canada

Ship To


DART AEROSPACE LTD
1270 ABERDEEN ST.
HAWKESBURY, ON K6A 1K7
Canada

Ph: 613-632-5200

Fax: 613-632-1185

Ph: 613-632-5200

Fax: 613-632-1185

Terms		Ship Via	
Quantity	Description		
1 lot	Part: ASST Rev: 10 PCS 646.3312 (12.05) ✓ 12 PCS 646.3010 (10.25) ✓ 6 PCS 646.3310 (18.10) ✓ 2 PCS 645.3110 (10.65) ✓ 4 PCS 646.3810 (6.55) ✓ 32 PCS 646.3715 (6.70) ✓ 16+808 38 PCS 646.3718 (3.95) ✓ 6 PCS 646.9812 (22.80) ✓ HARD ANODIZE BLACK MIL-A-8625 TYPE III CLASS 2 PRIME MIL-P-23377J TYPE I CLASS N PRICE IS PER PIECE Job: 20130724 PO: 21915 Line:		
Certificate of Conformance			
A.T.G. Industries certifies that all items in this shipment are in conformance with all requirements, specifications and drawings referenced in the purchase order.			
ISO 9001 : 2008 REGISTERED ATG SALES-2010 TERMS APPLY			
DATE: 22/11/13			
CERTIFIED SIGNATURE: 			
RECEIVER SIGNATURE: _____			